

Application Ref. No. 25/00199/FUL

66 Boulter Crescent, Wigston, Leicestershire, LE18 3WY


Change of use from community flat (office) into 2 bed flat, and
the removal of front canopy and removal of front door to
window.

Site Location




Red Line Plan



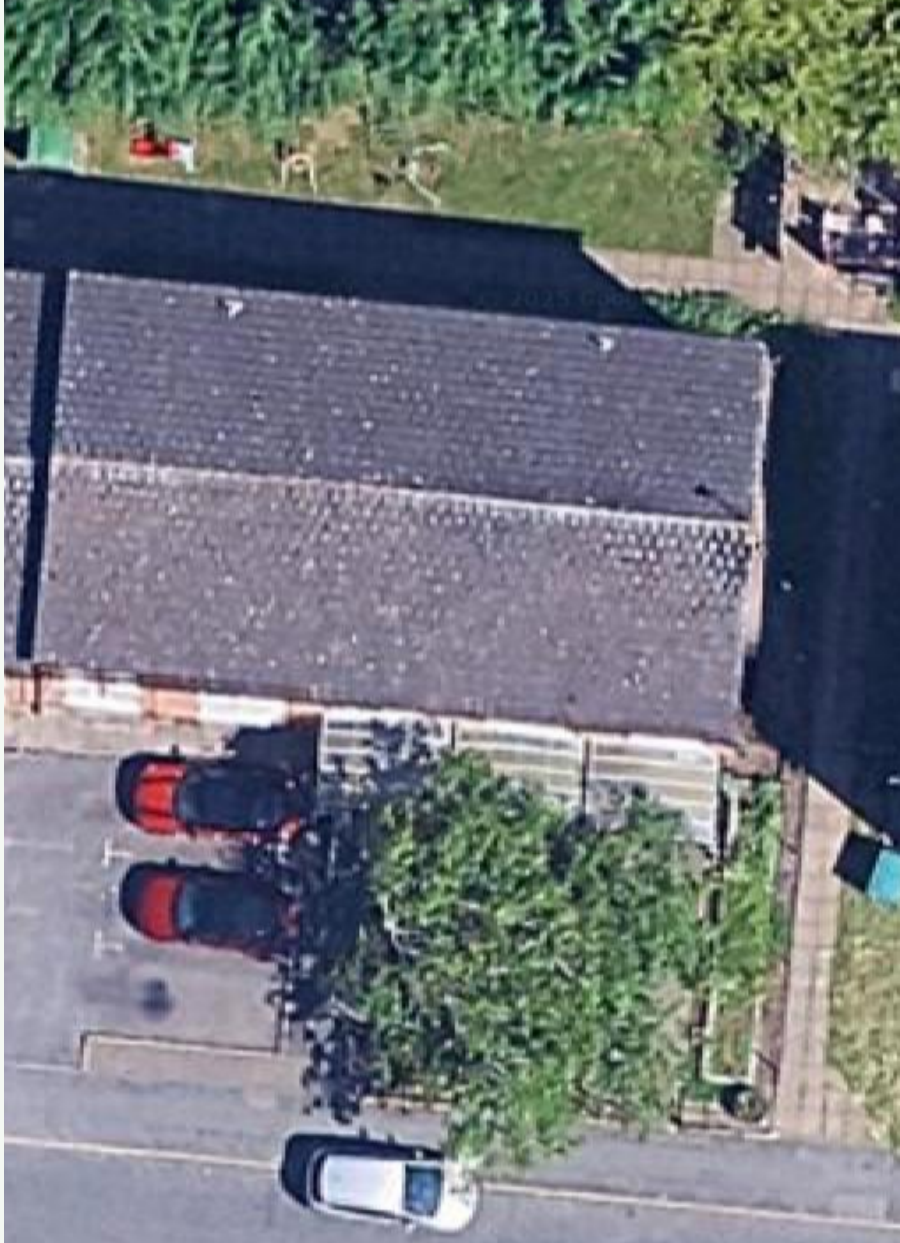


Existing Site Layout

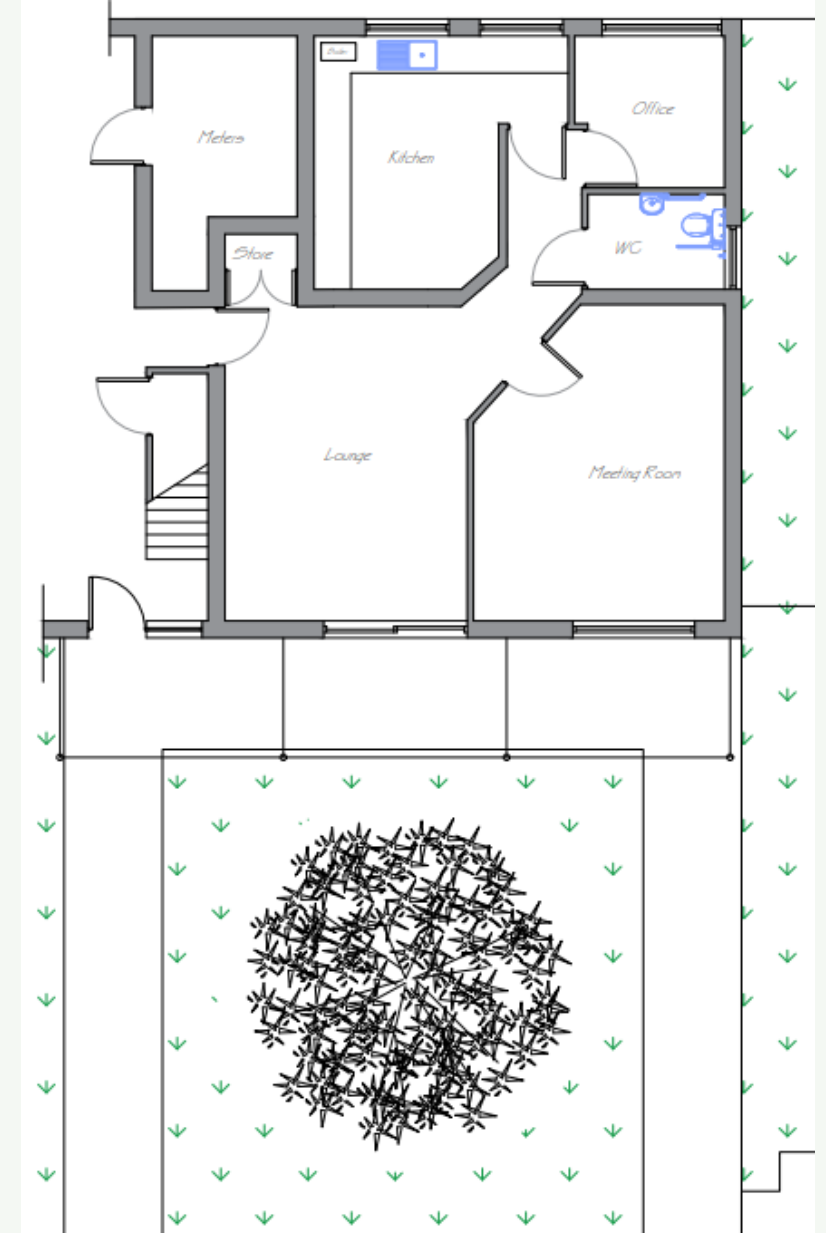


Existing Site Frontage




Proposed Layout

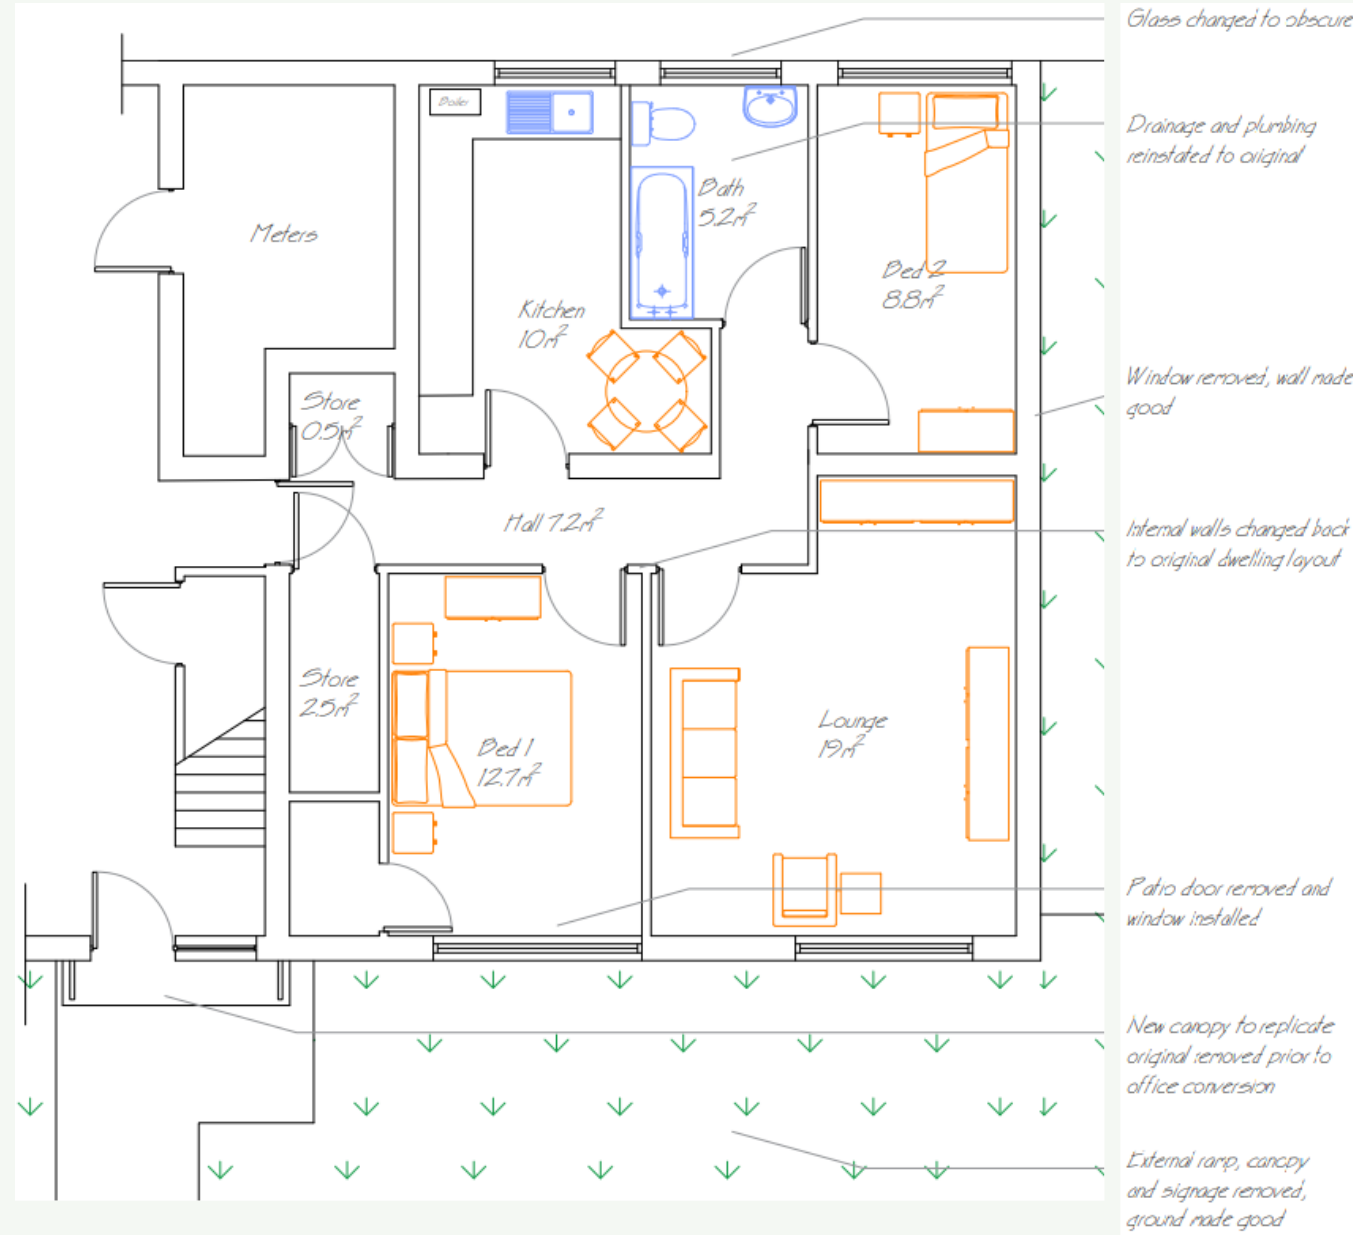

East Side Elevation

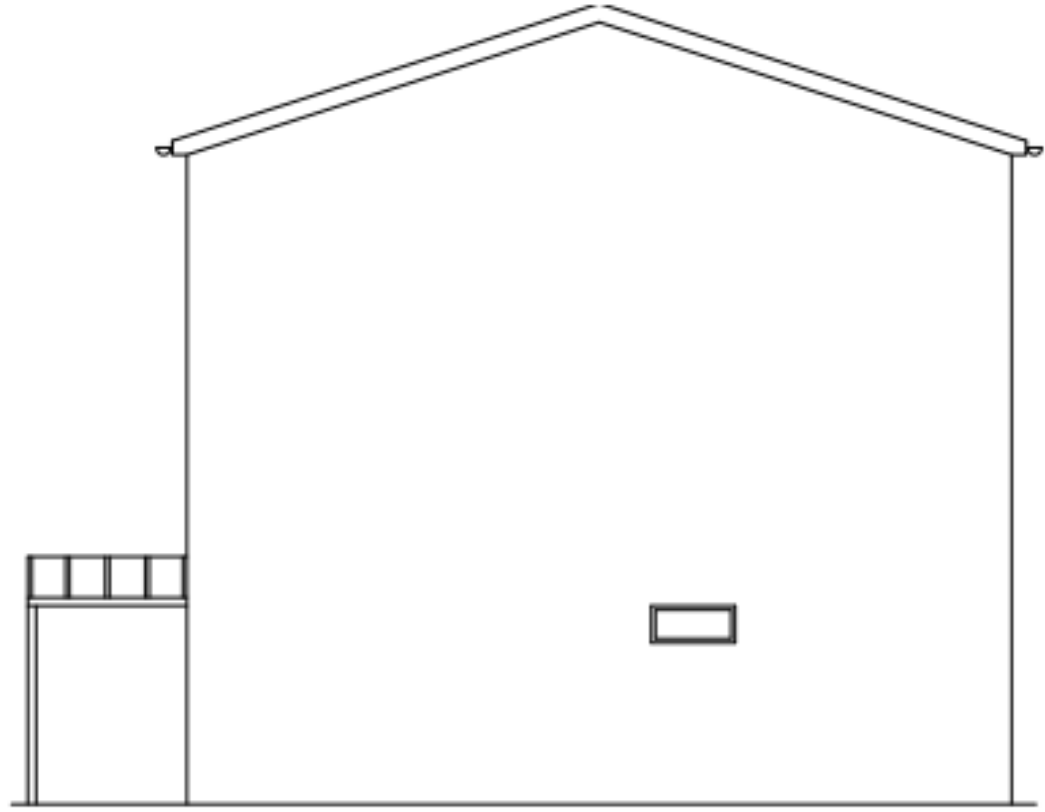

Existing Right (east) Elevation 1:100

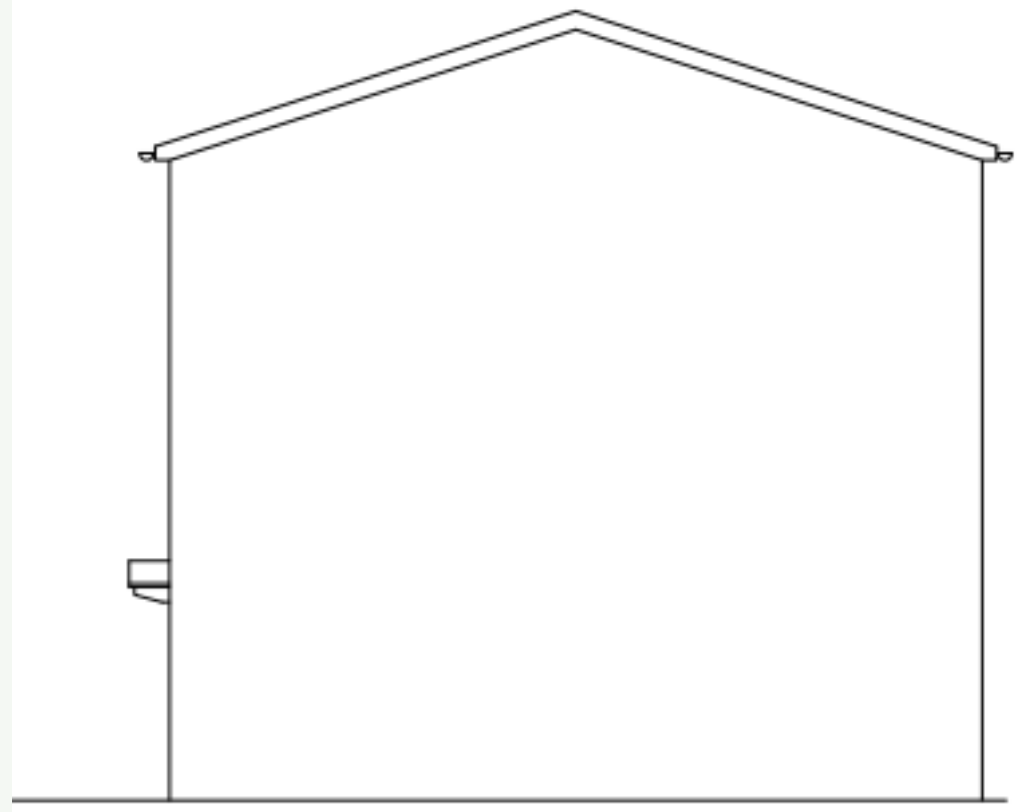

Proposed Right (east) Elevation 1:100

Front Elevation



Existing Front Elevation



Proposed Front Elevation